
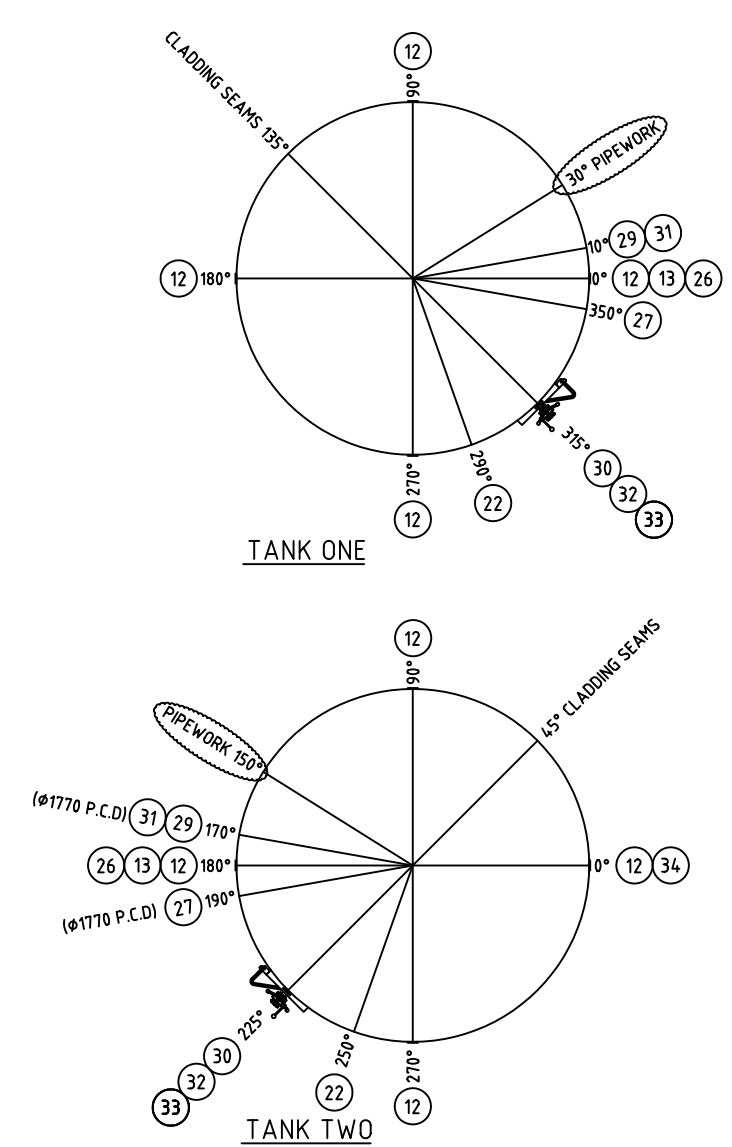


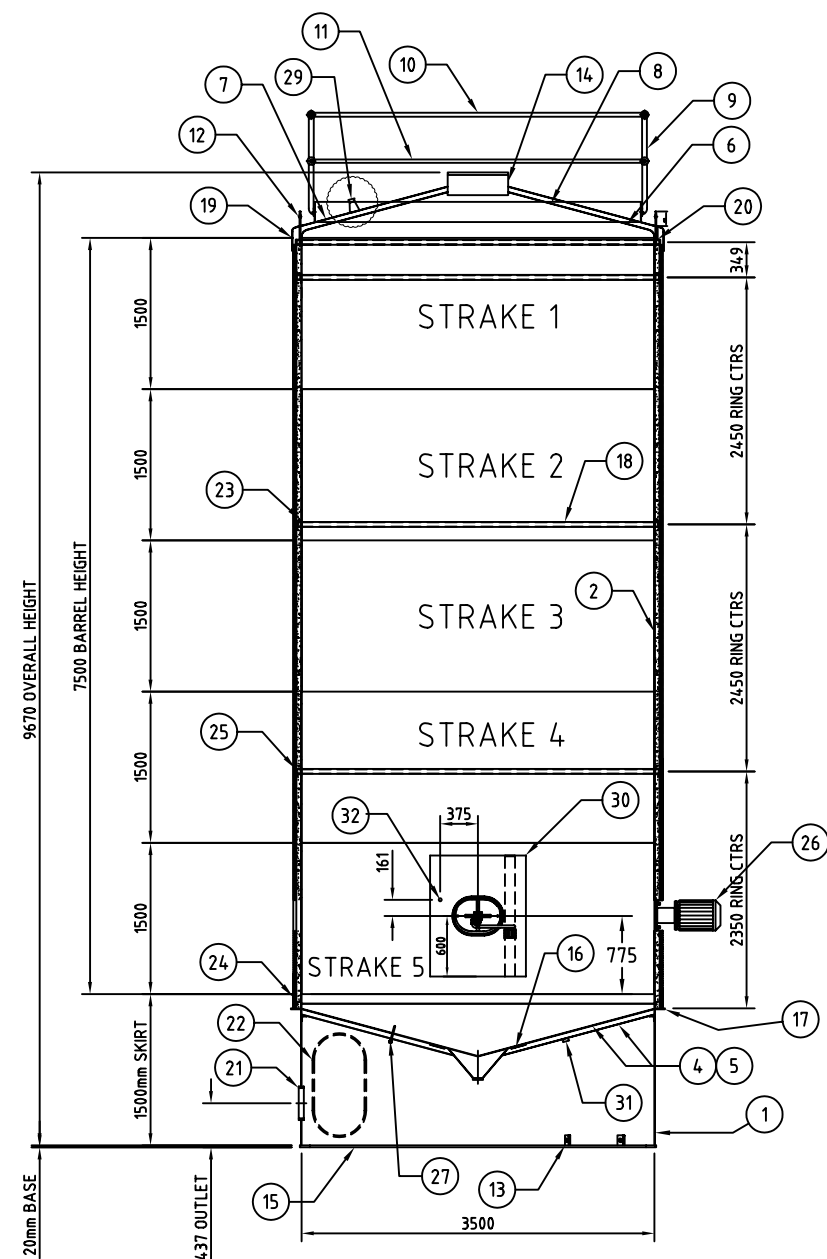

33	1	BRINE INLETS / OUTLETS	PURCHASE ITEM
32	1	SAMPLE TAP STANDARD GEORDI SANITRY	PURCHASE ITEM
31	1	LEVEL TRANSMITTER BENNEY SPUD (IN BASE 1770 P.C.D)	PURCHASE ITEM
30	1	STANDARD BYFORD MANWAY c/w FLASHING 1200 x 950	MS-MW-015-1
29	1	HIGH LEVEL SENSOR 51mm TRICLOVER (ø2500 P.C.D)	PURCHASE ITEM
28	1	-	PURCHASE ITEM
27	1	TEMPERATURE PROBE (IN BASE 1770 P.C.D)	PURCHASE ITEM
26	1	CPE SIDE ENTRY AGITATOR	PURCHASE ITEM
25	6	EVE 50 x 3 mm BLACK RUBBER STRIPS	PURCHASE ITEM
24	1	BOTTOM RETAINING BAND 200 x 2 S/S FLAT (ø3626 I.D) 11398 LONG	PURCHASE ITEM
23	6	WEAR STRIP 85 x 2mm S/S FLAT (ø3505 I.D) 11017 LONG	PURCHASE ITEM
22	1	SKIRT ACCESS COMP RING 50 x 16 S/S FLAT (ø500 I.D) 2258 LONG	PURCHASE ITEM
21	1	SKIRT OUTLET COMP RING 50 x 16 S/S FLAT (ø300 I.D) 993 LONG	PURCHASE ITEM
20	1	TOP CONE SUPPORT BAND 128x2mm S/S FLAT (ø3558 I.D) 11184 LONG	PURCHASE ITEM
19	1	TOP CLAD RETAINING BAND 200x3 S/S FLAT (ø3626 I.D) 11401 LONG	PURCHASE ITEM
18	6	STIFFENING RINGS 50 x 50 x 4 RHS (ø3509 I.D) 11181 LONG	PURCHASE ITEM
17	1	CLAD SUPPORT RING 100 x 10 S/S FLAT (ø3512 I.D) 11347 LONG	PURCHASE ITEM
16	1	OUTLET COMP RING 100 x 10 S/S FLAT (ø658 I.D) 2372 LONG	PURCHASE ITEM
15	1	BASE RING 100 x 20 S/S FLAT BAR (ø3336 I.D) 10794 LONG	PURCHASE ITEM
14	1	APEX (ø600)	MS-EX-5325-1
13	2	TAILING LUGS 100 x 20mm S/S 304 x 125 LONG	TL-001-1
12	4	LIFTING LUG 100 x 10mm S/S 304 x 365 LONG	MS-LL-5311-1
11	1	ø25NB GAL PIPE (ø3275 I.D) 10367 LONG	MS-HR-5325-1
10	1	ø32NB GAL PIPE (ø3268 I.D) 10342 LONG	MS-HR-5325-1
9	7	SC STANCHION	MS-HR-5325-1
8	1	KICKRAIL 200 x 4mm S/S 304 (ø3232 I.D) 10166mm LONG	MS-HR-5325-1
7	1	TOP CONE (OUTER) 2mm S/S 304	MS-TC-5325-2
6	1	TOP CONE (INNER) 3mm S/S 316	MS-TC-5325-1
5	1	CONE BASE (OUTER) 4mm S/S 316	MS-BS-5325-2
4	1	CONE BASE (INNER) 4mm S/S 316	MS-BS-5325-1
3	1	SUMP OUTLET ASSEMBLY	PURCHASE ITEM
2	1	BARREL LAYOUT	MS-BL-5325-1
1	1	SKIRT 1500 x 4mm S/S (3500 I.D) 11008mm LONG	PURCHASE ITEM
ITEM	QTY	DESCRIPTION	DRG No

F	STIFFENING RING CTRS REVISED	27.04.05	C.M	BYFORD EQUIPMENT Stainless Steel Specialists COBB HWY MOAMA 2731 TELEPHONE: 0354820666 FAX: 0354820667 EMAIL: admin@byfordequipment.com.au	PROJECT 70KL PALM OIL SILO		SCALE 1:50		A3
D	LOW LEVEL SENSOR REMOVED	15.04.05	C.M				DRAWN C.MARK		
C	SAMPLE TAP ADDED	01.04.05	C.M		DATE 29.03.05			JOB No. SG5325	
B	ITEMS 28 & 31 MOVED TO SUMP, ORIENTATIONS REVISED	01.04.05	C.M						
A	ISSUED FOR APPROVAL	29.03.05	C.M						
REV.	DESCRIPTION	DATE	BY	THIS DOCUMENT IS THE PROPERTY OF BYFORD EQUIPMENT AND MAY NOT BE REPRODUCED IN ANY FORM, BY ANY METHOD, FOR ANY PURPOSE, IN FULL OR IN PART, WITHOUT THE WRITTEN CONSENT OF THE COMPANY.	TITLE GENERAL ASSEMBLY		CLIENT LIQUID TECHNOLOGIES	DRAWING No. MS-GA-5325-1	